


# 上尾市中平塚土地区画整理事業出来形確認測量

## 画地原子図

平成十六年六月

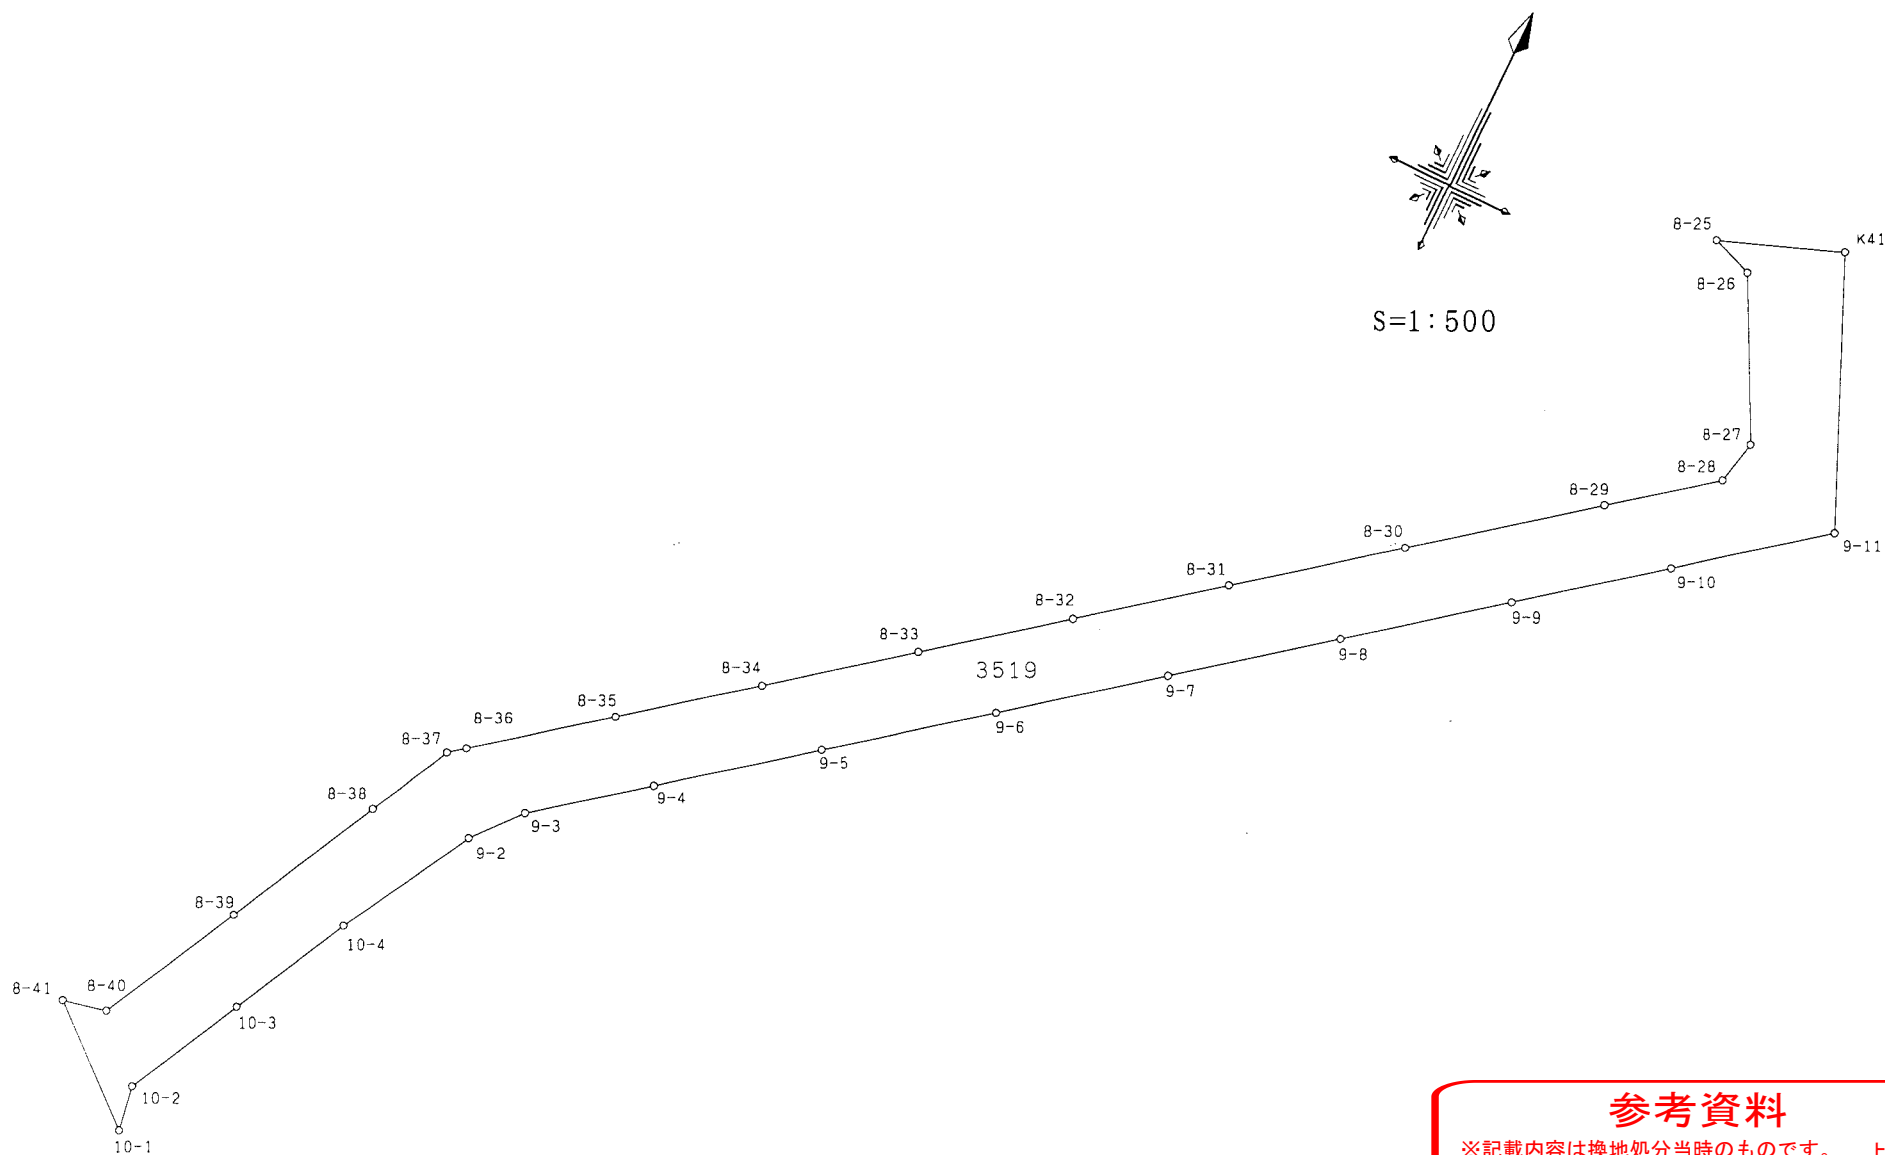

### 参考資料

※記載内容は換地処分当時のものです。 上尾市

# 画地面積計算書

現場名： 上尾市中平塚区画整理地内

画地番号： 3519

## 参考資料

※記載内容は換地処分当時のものです。 上尾市

点名	Xn	Yn	距離	方向角	測角	Xn+1-Xn-1	Yn+1-Yn-1	Yn*(Xn+1-Xn-1)	Xn*(Yn+1-Yn-1)
8-25	-1615.418	-20312.539	3.003	111°00'20"	41°00'24"	-4.004	-5.238	81331.406156	8461.559484
8-26	-1616.495	-20309.735	11.416	153°13'52"	222°13'32"	-11.269	7.946	228870.403715	-12844.669270
8-27	-1626.687	-20304.593	2.996	192°48'24"	219°34'32"	-13.114	4.478	266274.432602	-7284.304386
8-28	-1629.609	-20305.257	8.019	232°18'41"	219°30'17"	-7.824	-7.010	158868.330768	11423.559090
8-29	-1634.511	-20311.603	13.395	232°15'50"	179°57'09"	-13.100	-16.939	266081.999300	27686.981829
8-30	-1642.709	-20322.196	11.831	232°15'56"	180°00'06"	-15.439	-19.950	313754.384044	32772.044550
8-31	-1649.950	-20331.553	10.501	232°14'06"	179°58'10"	-13.672	-17.658	277972.992616	29134.817100
8-32	-1656.381	-20339.854	10.496	232°15'56"	180°01'50"	-12.855	-16.602	261468.823170	27499.237362
8-33	-1662.805	-20348.155	10.572	232°15'01"	179°59'05"	-12.896	-16.661	262409.806880	27703.994105
8-34	-1669.277	-20356.515	9.872	232°13'40"	179°58'39"	-12.519	-16.163	254843.211285	26980.524151
8-35	-1675.324	-20364.318	9.972	232°19'07"	180°05'27"	-12.143	-15.695	247283.913474	26294.210180
8-36	-1681.420	-20372.210	1.316	232°16'50"	179°57'43"	-6.901	-8.933	140588.621210	15020.124860
8-37	-1682.225	-20373.251	6.152	206°47'20"	154°30'30"	-6.297	-3.814	128290.361547	6416.006150
8-38	-1687.717	-20376.024	11.610	206°56'11"	180°08'51"	-15.842	-8.032	322796.972208	13555.742944
8-39	-1698.067	-20381.283	10.519	206°59'44"	180°03'33"	-19.722	-10.034	401959.663326	17038.404278
8-40	-1707.439	-20386.058	2.995	257°44'50"	230°45'06"	-10.008	-7.702	204023.668464	13150.695178
8-41	-1708.075	-20388.985	9.400	130°42'43"	52°57'53"	-6.767	4.198	137972.261495	-7170.498850
10-1	-1714.206	-20381.860	3.033	350°38'10"	39°55'27"	-3.139	6.632	63978.658540	-11368.614192
10-2	-1711.214	-20382.353	8.644	27°00'56"	216°22'46"	10.693	3.433	-217948.500629	-5874.597662
10-3	-1703.513	-20378.427	8.935	26°56'41"	179°55'45"	15.666	7.975	-319248.437382	-13585.516175
10-4	-1695.548	-20374.378	10.068	29°04'22"	182°07'41"	16.764	8.941	-341556.072792	-15159.894668
9-2	-1686.749	-20369.486	4.033	39°52'08"	190°47'46"	11.895	7.478	-242295.035970	-12613.509022
9-3	-1683.653	-20366.900	8.693	52°17'09"	192°25'01"	8.413	9.462	-171346.729700	-15930.724686
9-4	-1678.336	-20360.024	11.306	52°15'26"	179°58'17"	12.238	15.817	-249165.973712	-26546.240512
9-5	-1671.415	-20351.083	11.796	52°15'46"	180°00'20"	14.140	18.269	-287764.313620	-30535.080635
9-6	-1664.196	-20341.755	11.648	52°14'43"	179°58'57"	14.351	18.537	-291924.526005	-30849.201252
9-7	-1657.064	-20332.546	11.529	52°13'44"	179°59'01"	14.194	18.323	-288600.157924	-30362.383672
9-8	-1650.002	-20323.432	11.515	52°16'31"	180°02'47"	14.108	18.221	-286722.978656	-30064.686442
9-9	-1642.956	-20314.325	10.738	52°13'39"	179°57'08"	13.623	17.595	-276742.049475	-28907.810820
9-10	-1636.379	-20305.837	11.111	52°12'33"	179°58'54"	13.386	17.269	-271813.934082	-28258.628951
9-11	-1629.570	-20297.056	18.630	336°27'32"	104°14'59"	23.888	1.340	-484856.073728	-2183.623800
K41	-1612.491	-20304.497	8.558	249°59'56"	93°32'24"	14.152	-15.483	-287349.241544	24966.198153

倍面積	1435.885581
面積	717.9427905
地積	717.94㎡