



上尾市中平塚土地区画整理事業出来形確認測量

画地原子図

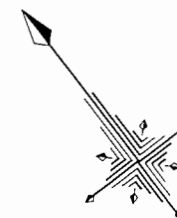

S=1:400

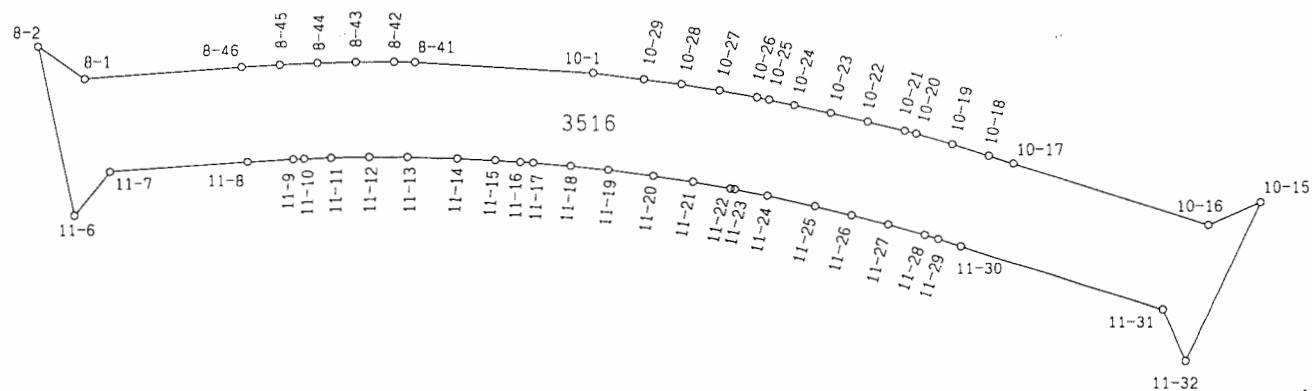

参考資料

※記載内容は換地処分当時のものです。 上尾市

画地面積計算書

現場名：上尾市中平塚区画整理地内

画地番号：3516

参考資料

※記載内容は換地処分当時のものです。 上尾市

点名	Xn	Yn	距離	方向角	測角	Xn+1-Xn-1	Yn+1-Yn-1	Yn*(Xn+1-Xn-1)	Xn*(Yn+1-Yn-1)
11-6	-1703.680	-20408.141	2.990	76° 11' 19"	51° 04' 24"	-7.577	-0.983	154632.484357	1674.717440
11-7	-1702.966	-20405.238	7.243	123° 06' 54"	226° 55' 35"	-3.243	8.969	66174.186834	-15273.902054
11-8	-1706.923	-20399.172	2.436	124° 01' 57"	180° 55' 03"	-5.320	8.085	108523.595040	-13800.472455
11-9	-1708.286	-20397.153	0.577	124° 51' 57"	180° 50' 00"	-1.693	2.493	34532.380029	-4258.756998
11-10	-1708.616	-20396.679	1.414	124° 58' 46"	180° 06' 49"	-1.141	1.633	23272.610739	-2790.169928
11-11	-1709.427	-20395.520	2.009	126° 08' 31"	181° 09' 45"	-1.996	2.781	40709.457920	-4753.916487
11-12	-1710.612	-20393.898	1.997	127° 18' 01"	181° 09' 30"	-2.395	3.211	48843.385710	-5492.775132
11-13	-1711.822	-20392.309	2.603	128° 55' 05"	181° 37' 04"	-2.845	3.614	58016.119105	-6186.524708
11-14	-1713.457	-20390.284	1.997	130° 04' 22"	181° 09' 17"	-2.921	3.553	59560.019564	-6087.912721
11-15	-1714.743	-20388.756	1.334	131° 15' 14"	181° 10' 52"	-2.165	2.531	44141.656740	-4340.014533
11-16	-1715.622	-20387.753	0.667	131° 12' 30"	179° 57' 16"	-1.318	1.504	26871.058454	-2580.295488
11-17	-1716.061	-20387.252	2.000	132° 14' 47"	181° 02' 17"	-1.784	1.981	36370.857568	-3399.516841
11-18	-1717.406	-20385.772	2.004	133° 11' 50"	180° 57' 03"	-2.716	2.941	55367.756752	-5050.891046
11-19	-1718.777	-20384.311	2.414	135° 03' 17"	181° 51' 27"	-3.080	3.167	62783.677880	-5443.366759
11-20	-1720.486	-20382.605	2.112	135° 47' 47"	180° 44' 30"	-3.223	3.178	65693.135915	-5467.704508
11-21	-1722.000	-20381.133	1.997	137° 24' 17"	181° 36' 30"	-2.985	2.824	60837.682005	-4862.928000
11-22	-1723.471	-20379.781	0.236	138° 14' 56"	180° 50' 39"	-1.647	1.509	33565.499307	-2600.717739
11-23	-1723.647	-20379.624	1.760	138° 24' 31"	180° 09' 35"	-1.492	1.326	30406.399008	-2285.555922
11-24	-1724.963	-20378.455	2.604	139° 59' 10"	181° 34' 39"	-3.311	2.843	67473.064505	-4904.069809
11-25	-1726.958	-20376.781	2.001	140° 39' 21"	180° 40' 11"	-3.542	2.943	72174.558302	-5082.437394
11-26	-1728.505	-20375.512	1.997	141° 24' 01"	180° 44' 40"	-3.108	2.514	63327.091296	-4345.461570
11-27	-1730.066	-20374.267	2.000	143° 25' 03"	182° 01' 02"	-3.166	2.437	64504.929322	-4216.170842
11-28	-1731.671	-20373.075	0.743	144° 42' 48"	181° 17' 45"	-2.212	1.621	45065.241900	-2807.038691
11-29	-1732.278	-20372.646	1.262	144° 37' 29"	179° 54' 41"	-1.636	1.160	33329.648856	-2009.442480
11-30	-1733.307	-20371.915	11.131	144° 50' 10"	180° 12' 41"	-10.128	7.141	206326.755120	-12377.545287
11-31	-1742.406	-20365.505	3.010	193° 51' 55"	229° 01' 45"	-12.022	5.689	244834.101110	-9912.547734
11-32	-1745.329	-20366.226	9.302	62° 19' 14"	48° 27' 19"	1.398	7.516	-28471.983948	-13117.892764
10-15	-1741.008	-20357.989	2.976	283° 45' 47"	41° 26' 33"	5.029	5.347	-102380.326681	-9309.169776
10-16	-1740.300	-20360.879	10.753	324° 56' 53"	221° 11' 06"	9.511	-9.065	-193652.320169	15775.819500
10-17	-1731.497	-20367.054	1.368	324° 53' 45"	179° 56' 52"	9.922	-6.962	-202081.909788	12054.682114
10-18	-1730.378	-20367.841	2.012	324° 38' 10"	179° 44' 25"	2.760	-1.952	-56215.241160	3377.697856
10-19	-1728.737	-20369.006	1.997	323° 27' 13"	178° 49' 03"	3.245	-2.354	-66097.424470	4069.446898
10-20	-1727.133	-20370.195	0.625	322° 04' 25"	178° 37' 12"	2.097	-1.573	-42716.298915	2716.780209
10-21	-1726.640	-20370.579	2.013	320° 59' 23"	178° 54' 58"	2.057	-1.651	-41902.281003	2850.682640
10-22	-1725.076	-20371.846	2.003	320° 29' 16"	179° 29' 53"	3.109	-2.541	-63336.069214	4383.418116
10-23	-1723.531	-20373.120	2.012	319° 59' 41"	179° 30' 25"	3.086	-2.568	-62871.448320	4426.027608
10-24	-1721.990	-20374.414	1.359	319° 00' 06"	179° 00' 25"	2.567	-2.185	-52301.120738	3762.548150
10-25	-1720.964	-20375.305	0.655	319° 08' 08"	180° 08' 02"	1.522	-1.320	-31011.214210	2271.672480
10-26	-1720.468	-20375.734	2.011	317° 22' 27"	178° 14' 19"	1.976	-1.791	-40262.450384	3081.358188

点名	X _n	Y _n	距離	方向角	測角	X _{n+1} —X _{n-1}	Y _{n+1} —Y _{n-1}	Y _n *(X _{n+1} —X _{n-1})	X _n *(Y _{n+1} —Y _{n-1})
10-27	-1718.988	-20377.096	2.029	316°32'36"	179°10'09"	2.952	-2.757	-60153.187392	4739.249916
10-28	-1717.516	-20378.491	2.001	314°32'53"	178°00'17"	2.876	-2.822	-58608.540116	4846.830152
10-29	-1716.112	-20379.918	2.721	314°27'54"	179°55'01"	3.310	-3.369	-67457.528580	5781.581328
10-1	-1714.206	-20381.860	9.400	310°42'43"	176°14'49"	8.037	-9.067	-163809.008820	15542.705802
8-41	-1708.075	-20388.985	1.089	307°56'29"	177°13'46"	6.801	-7.984	-138665.486985	13637.270800
8-42	-1707.405	-20389.844	2.012	307°03'09"	179°06'40"	1.882	-2.464	-38373.686408	4207.045920
8-43	-1706.193	-20391.449	2.004	305°47'10"	178°44'01"	2.384	-3.231	-48613.214416	5512.709583
8-44	-1705.021	-20393.075	1.998	304°43'03"	178°55'53"	2.310	-3.268	-47108.003250	5572.008628
8-45	-1703.883	-20394.717	2.027	304°00'17"	179°17'14"	2.271	-3.323	-46316.402307	5662.003209
8-46	-1702.750	-20396.398	8.270	303°01'55"	179°01'38"	5.641	-8.614	-115056.081118	14667.488500
8-1	-1698.242	-20403.331	2.999	342°03'09"	219°01'14"	7.361	-7.857	-150188.919491	13343.087394
8-2	-1695.389	-20404.255	9.157	205°06'55"	43°03'46"	-5.438	-4.810	110958.338690	8154.821090

倍面積	645.544145
面積	322.7720725
地積	322.77㎡