
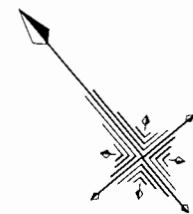


上尾市中平塚土地区画整理事業出来形確認測量

画地原子図

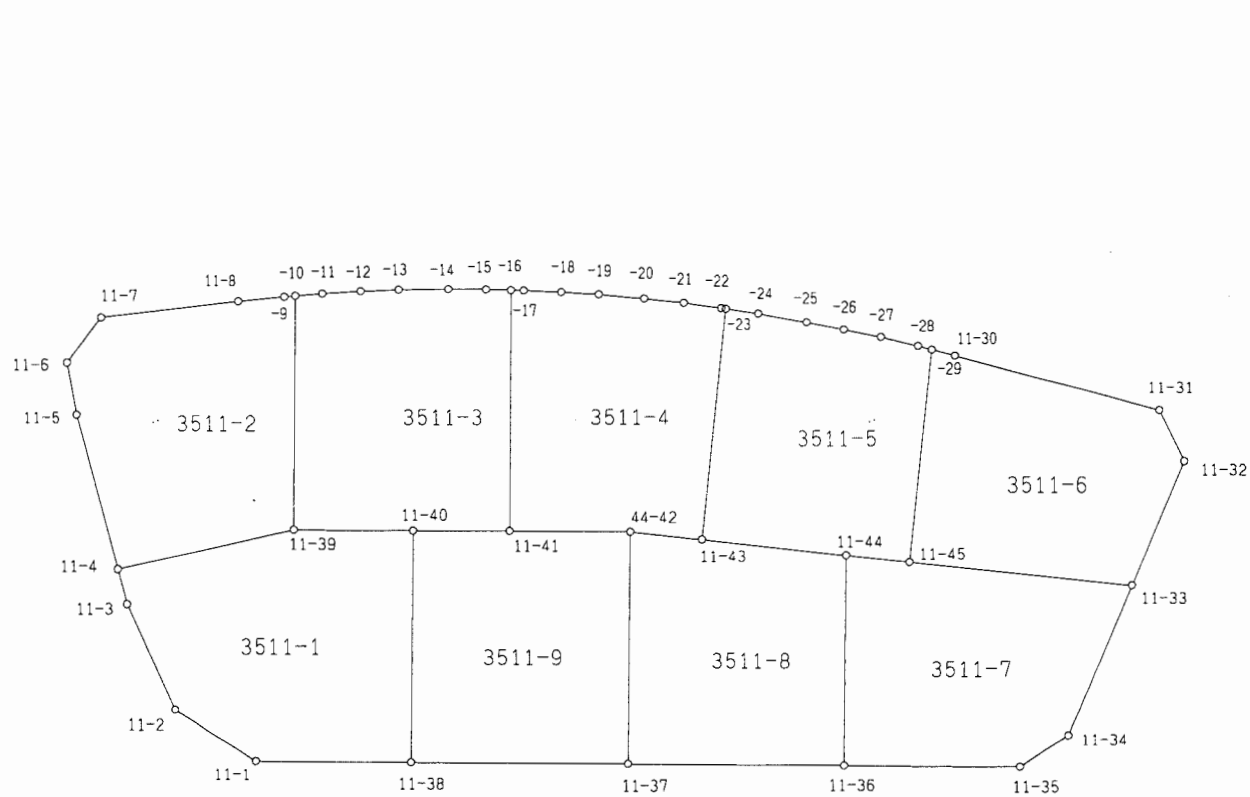

S=1:400

参考資料

※記載内容は換地処分当時のものです。 上尾市

画地面積計算書

現場名：上尾市中平塚区画整理地内

画地番号：3511-1(11-1)

参考資料

※記載内容は換地処分当時のものです。上尾市

点名	X _n	Y _n	距離	方向角	測角	X _{n+1} -X _{n-1}	Y _{n+1} -Y _{n-1}	Y _n *(X _{n+1} -X _{n-1})	X _n *(Y _{n+1} -Y _{n-1})
11-2	-1721.434	-20415.464	5.071	162°31'15"	147°13'16"	-10.757	-0.096	219609.146248	165.257664
11-1	-1726.271	-20413.941	8.106	130°04'01"	147°32'46"	-10.055	7.726	205262.176755	-13337.169746
11-38	-1731.489	-20407.738	12.240	40°07'45"	90°03'44"	4.141	14.092	-84508.443058	-24400.142988
11-40	-1722.130	-20399.849	6.246	310°01'00"	89°53'15"	13.376	3.106	-272868.380224	-5348.935780
11-39	-1718.113	-20404.632	9.460	297°14'04"	167°13'04"	8.346	-13.194	-170297.058672	22668.782922
11-4	-1713.784	-20413.043	1.906	204°51'16"	87°37'12"	2.599	-9.213	-53053.498757	15789.091992
11-3	-1715.514	-20413.845	6.138	195°17'59"	170°26'43"	-7.650	-2.421	156165.914250	4153.259394

倍面積	309.856542
面積	154.9282710
地積	154.92㎡

画地番号：3511-2(11-2)

点名	X _n	Y _n	距離	方向角	測角	X _{n+1} -X _{n-1}	Y _{n+1} -Y _{n-1}	Y _n *(X _{n+1} -X _{n-1})	X _n *(Y _{n+1} -Y _{n-1})
11-4	-1713.784	-20413.043	9.460	117°14'04"	92°31'22"	-11.976	4.892	244466.602968	-8383.831328
11-39	-1718.113	-20404.632	12.387	39°56'40"	102°42'36"	5.168	16.364	-105451.138176	-28115.201132
11-10	-1708.616	-20396.679	0.577	304°51'57"	84°55'17"	9.827	7.479	-200438.164533	-12778.739064
11-9	-1708.286	-20397.153	2.436	304°01'57"	179°10'00"	1.693	-2.493	-34532.380029	4258.756998
11-8	-1706.923	-20399.172	7.243	303°06'54"	179°04'57"	5.320	-8.085	-108523.595040	13800.472455
11-7	-1702.966	-20405.238	2.990	256°11'19"	133°04'25"	3.243	-8.969	-66174.186834	15273.902054
11-6	-1703.680	-20408.141	2.820	209°22'10"	133°10'51"	-3.171	-4.286	64714.215111	7301.972480
11-5	-1706.137	-20409.524	8.418	204°42'42"	175°20'32"	-10.104	-4.902	206217.830496	8363.483574

倍面積	279.183963
面積	139.5919815
地積	139.59㎡

画地面積計算書

現場名：上尾市中平塚区画整理地内

画地番号：3511-3(11-3)

参考資料

※記載内容は換地処分当時のものです。上尾市

点名	Xn	Yn	距離	方向角	測角	Xn+1-Xn-1	Yn+1-Yn-1	Yn*(Xn+1-Xn-1)	Xn*(Yn+1-Yn-1)
11-39	-1718.113	-20404.632	6.246	130°01'00"	90°04'20"	-13.514	-3.170	275748.196848	5446.418210
11-40	-1722.130	-20399.849	5.094	130°01'08"	180°00'08"	-7.292	8.685	148755.698908	-14956.699050
11-41	-1725.405	-20395.947	12.761	39°56'51"	89°55'43"	6.508	12.096	-132736.823076	-20870.498880
11-16	-1715.622	-20387.753	1.334	311°15'14"	91°18'23"	10.662	7.191	-217374.222486	-12337.037802
11-15	-1714.743	-20388.756	1.997	310°04'22"	178°49'08"	2.165	-2.531	-44141.656740	4340.014533
11-14	-1713.457	-20390.284	2.603	308°55'05"	178°50'43"	2.921	-3.553	-59560.019564	6087.912721
11-13	-1711.822	-20392.309	1.997	307°18'01"	178°22'56"	2.845	-3.614	-58016.119105	6186.524708
11-12	-1710.612	-20393.898	2.009	306°08'31"	178°50'30"	2.395	-3.211	-48843.385710	5492.775132
11-11	-1709.427	-20395.520	1.414	304°58'46"	178°50'15"	1.996	-2.781	-40709.457920	4753.916487
11-10	-1708.616	-20396.679	12.387	219°56'40"	94°57'54"	-8.686	-9.112	177165.553794	15568.908992

倍面積	287.764949
面積	143.8824745
地積	143.88㎡

画地番号：3511-4(11-4)

点名	Xn	Yn	距離	方向角	測角	Xn+1-Xn-1	Yn+1-Yn-1	Yn*(Xn+1-Xn-1)	Xn*(Yn+1-Yn-1)
11-41	-1725.405	-20395.947	6.406	130°00'26"	90°03'35"	-13.902	-3.287	283544.455194	5671.406235
11-42	-1729.524	-20391.040	3.821	135°47'12"	185°46'46"	-6.858	7.571	139841.752320	-13094.226204
11-43	-1732.263	-20388.376	12.282	45°26'55"	89°39'43"	5.877	11.416	-119822.485752	-19775.514408
11-23	-1723.647	-20379.624	0.236	318°14'56"	92°48'01"	8.792	8.595	-179177.654208	-14814.745965
11-22	-1723.471	-20379.781	1.997	317°24'17"	179°09'21"	1.647	-1.509	-33565.499307	2600.717739
11-21	-1722.000	-20381.133	2.112	315°47'47"	178°23'30"	2.985	-2.824	-60837.682005	4862.928000
11-20	-1720.486	-20382.605	2.414	315°03'17"	179°15'30"	3.223	-3.178	-65693.135915	5467.704508
11-19	-1718.777	-20384.311	2.004	313°11'50"	178°08'33"	3.080	-3.167	-62783.677880	5443.366759
11-18	-1717.406	-20385.772	2.000	312°14'47"	179°02'57"	2.716	-2.941	-55367.756752	5050.891046
11-17	-1716.061	-20387.252	0.667	311°12'30"	178°57'43"	1.784	-1.981	-36370.857568	3399.516841
11-16	-1715.622	-20387.753	12.761	219°56'51"	88°44'21"	-9.344	-8.695	190503.164032	14917.333290

倍面積	270.622159
面積	135.3110795
地積	135.31㎡

画地面積計算書

現場名： 上尾市中平塚区画整理地内

画地番号： 3511-5 (11-5)

参考資料

※記載内容は換地処分当時のものです。 上尾市

点名	Xn	Yn	距離	方向角	測角	Xn+1-Xn-1	Yn+1-Yn-1	Yn*(Xn+1-Xn-1)	Xn*(Yn+1-Yn-1)
11-43	-1732.263	-20388.376	7.688	135°47'53"	90°20'58"	-14.127	-3.392	288026.587752	5875.836096
11-44	-1737.774	-20383.016	3.351	135°47'06"	179°59'13"	-7.913	7.697	161290.805608	-13375.646478
11-45	-1740.176	-20380.679	11.266	45°29'02"	89°41'56"	5.496	10.370	-112012.211784	-18045.625120
11-29	-1732.278	-20372.646	0.743	324°42'48"	99°13'46"	8.505	7.604	-173269.354230	-13172.241912
11-28	-1731.671	-20373.075	2.000	323°25'03"	178°42'15"	2.212	-1.621	-45065.241900	2807.038691
11-27	-1730.066	-20374.267	1.997	321°24'01"	177°58'58"	3.166	-2.437	-64504.929322	4216.170842
11-26	-1728.505	-20375.512	2.001	320°39'21"	179°15'20"	3.108	-2.514	-63327.091296	4345.461570
11-25	-1726.958	-20376.781	2.604	319°59'10"	179°19'49"	3.542	-2.943	-72174.558302	5082.437394
11-24	-1724.963	-20378.455	1.760	318°24'31"	178°25'21"	3.311	-2.843	-67473.064505	4904.069809
11-23	-1723.647	-20379.624	12.282	225°26'55"	87°02'24"	-7.300	-9.921	148771.255200	17100.301887

倍面積	262.197221
面積	131.0986105
地積	131.09㎡

画地番号： 3511-6 (11-6)

点名	Xn	Yn	距離	方向角	測角	Xn+1-Xn-1	Yn+1-Yn-1	Yn*(Xn+1-Xn-1)	Xn*(Yn+1-Yn-1)
11-45	-1740.176	-20380.679	11.730	135°47'08"	90°18'06"	-16.305	0.147	332306.971095	-255.805872
11-33	-1748.583	-20372.499	7.067	62°34'46"	106°47'38"	-5.153	14.453	104979.487347	-25272.270099
11-32	-1745.329	-20366.226	3.010	13°51'55"	131°17'09"	6.177	6.994	-125802.178002	-12206.831026
11-31	-1742.406	-20365.505	11.131	324°50'10"	130°58'15"	12.022	-5.689	-244834.101110	9912.547734
11-30	-1733.307	-20371.915	1.262	324°37'29"	179°47'19"	10.128	-7.141	-206326.755120	12377.545287
11-29	-1732.278	-20372.646	11.266	225°29'02"	80°51'33"	-6.869	-8.764	139939.705374	15181.684392

倍面積	263.129584
面積	131.5647920
地積	131.56㎡

画地番号： 3511-7 (11-7)

点名	Xn	Yn	距離	方向角	測角	Xn+1-Xn-1	Yn+1-Yn-1	Yn*(Xn+1-Xn-1)	Xn*(Yn+1-Yn-1)
11-36	-1746.277	-20390.182	9.227	130°12'58"	90°05'18"	-14.460	-0.121	294842.031720	211.299517
11-35	-1752.234	-20383.137	2.997	96°16'01"	146°03'03"	-6.284	10.025	128087.632908	-17566.145850
11-34	-1752.561	-20380.157	8.630	62°33'01"	146°17'00"	3.651	10.638	-74407.953207	-18643.743918
11-33	-1748.583	-20372.499	11.730	315°47'08"	73°14'07"	12.385	-0.522	-252313.400115	912.760326
11-45	-1740.176	-20380.679	3.351	315°47'06"	179°59'58"	10.809	-10.517	-220294.759311	18301.430992
11-44	-1737.774	-20383.016	11.120	220°07'40"	84°20'34"	-6.101	-9.503	124356.780616	16514.066322

倍面積	270.332611
面積	135.1663055
地積	135.16㎡

画地面積計算書

現場名： 上尾市中平塚区画整理地内

画地番号： 3511-8 (11-8)

参考資料

※記載内容は換地処分当時のものです。 上尾市

点名	Xn	Yn	距離	方向角	測角	Xn+1-Xn-1	Yn+1-Yn-1	Yn*(Xn+1-Xn-1)	Xn*(Yn+1-Yn-1)
11-37	-1738.891	-20398.949	11.463	130°06'54"	89°56'29"	-16.753	0.858	341743.592597	-1491.968478
11-36	-1746.277	-20390.182	11.120	40°07'40"	90°00'46"	1.117	15.933	-22775.833294	-27823.431441
11-44	-1737.774	-20383.016	7.688	315°47'53"	95°40'13"	14.014	1.806	-285647.586224	-3138.419844
11-43	-1732.263	-20388.376	3.821	315°47'12"	179°59'19"	8.250	-8.024	-168204.102000	13899.678312
11-42	-1729.524	-20391.040	12.259	220°10'25"	84°23'13"	-6.628	-10.573	135151.813120	18286.257252

倍面積	267.884199
面積	133.9420995
地積	133.94㎡

画地番号： 3511-9 (11-9)

点名	Xn	Yn	距離	方向角	測角	Xn+1-Xn-1	Yn+1-Yn-1	Yn*(Xn+1-Xn-1)	Xn*(Yn+1-Yn-1)
11-38	-1731.489	-20407.738	11.491	130°06'18"	89°58'33"	-16.761	0.900	342054.096618	-1558.340100
11-37	-1738.891	-20398.949	12.259	40°10'25"	90°04'07"	1.965	16.698	-40083.934785	-29036.001918
11-42	-1729.524	-20391.040	6.406	310°00'26"	89°50'01"	13.486	3.002	-274993.565440	-5192.031048
11-41	-1725.405	-20395.947	5.094	310°01'08"	180°00'42"	7.394	-8.809	-150807.632118	15199.092645
11-40	-1722.130	-20399.849	12.240	220°07'45"	90°06'37"	-6.084	-11.791	124112.681316	20305.634830

倍面積	281.645591
面積	140.8227955
地積	140.82㎡