


上尾市中平塚土地区画整理事業出来形確認測量 画地原子図

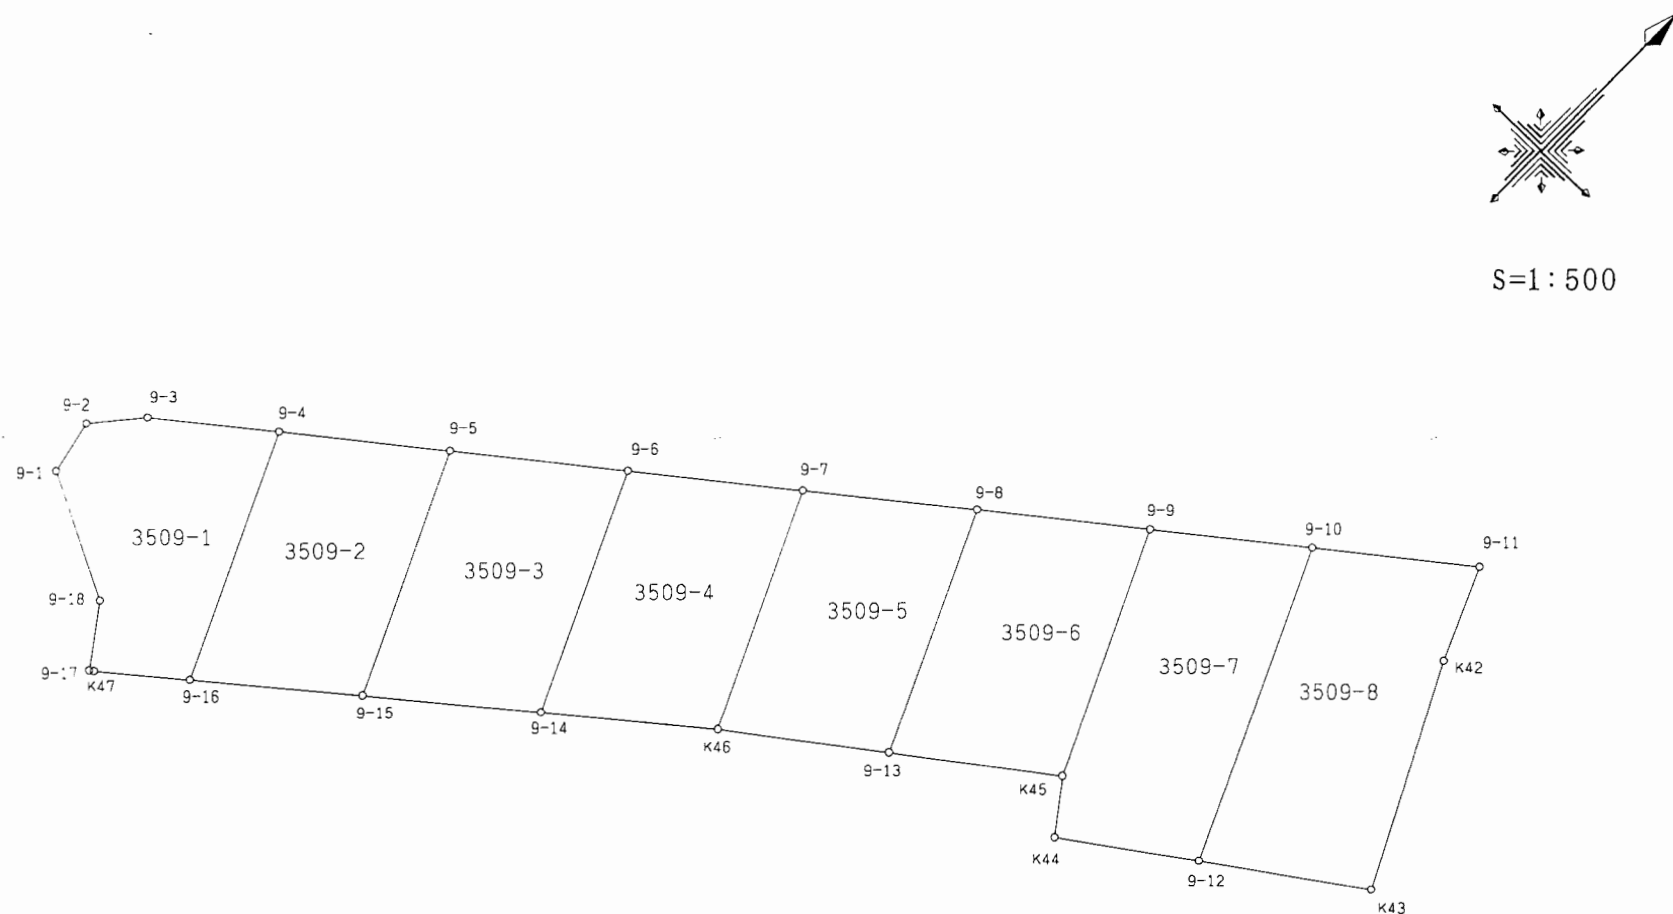

参考資料

※記載内容は換地処分当時のものです。 上尾市

画地面積計算書

現場名： 上尾市中平塚区画整理地内

画地番号： 3509-1(9-1)

参考資料

※記載内容は換地処分当時のものです。 上尾市

点名	Xn	Yn	距離	方向角	測角	X _{n+1} -X _{n-1}	Y _{n+1} -Y _{n-1}	Y _n *(X _{n+1} -X _{n-1})	X _n *(Y _{n+1} -Y _{n-1})
9-2	-1686.749	-20369.486	3.752	168°26'51"	128°34'43"	-6.772	-1.834	137942.159192	3093.497666
9-1	-1690.425	-20368.734	9.048	116°51'53"	128°25'02"	-7.765	8.824	158163.219510	-14916.310200
9-18	-1694.514	-20360.662	4.664	144°21'23"	207°29'30"	-7.879	10.789	160421.655898	-18282.111546
9-17	-1698.304	-20357.945	0.317	54°04'05"	89°42'42"	-3.604	2.974	73370.033780	-5050.756096
K47	-1698.118	-20357.688	6.300	51°12'28"	177°08'23"	4.133	5.167	-84138.324504	-8774.175706
9-16	-1694.171	-20352.778	17.414	335°24'43"	104°12'15"	19.782	-2.336	-402618.654396	3957.583456
9-4	-1678.336	-20360.024	8.693	232°17'09"	76°52'26"	10.518	-14.122	-214146.732432	23701.460992
9-3	-1683.653	-20366.900	4.033	219°52'08"	167°34'59"	-8.413	-9.462	171346.729700	15930.724686

倍面積	340.086748
面積	170.0433740
地積	170.04㎡

画地番号： 3509-2(9-2)

点名	Xn	Yn	距離	方向角	測角	X _{n+1} -X _{n-1}	Y _{n+1} -Y _{n-1}	Y _n *(X _{n+1} -X _{n-1})	X _n *(Y _{n+1} -Y _{n-1})
9-4	-1678.336	-20360.024	17.414	155°24'43"	103°09'17"	-22.756	-1.695	463312.706144	2844.779520
9-16	-1694.171	-20352.778	11.345	51°09'19"	75°44'36"	-8.719	16.083	177455.871382	-27247.352193
9-15	-1687.055	-20343.941	17.194	335°27'23"	104°18'04"	22.756	1.695	-462946.721396	-2859.558225
9-5	-1671.415	-20351.083	11.306	232°15'26"	76°48'03"	8.719	-16.083	-177441.092677	26881.367445

倍面積	380.763453
面積	190.3817265
地積	190.38㎡

画地番号： 3509-3(9-3)

点名	Xn	Yn	距離	方向角	測角	X _{n+1} -X _{n-1}	Y _{n+1} -Y _{n-1}	Y _n *(X _{n+1} -X _{n-1})	X _n *(Y _{n+1} -Y _{n-1})
9-5	-1671.415	-20351.083	17.194	155°27'23"	103°11'37"	-22.859	-2.186	465205.406297	3653.713190
9-15	-1687.055	-20343.941	11.850	51°11'04"	75°43'41"	-8.212	16.374	167064.443492	-27623.838570
9-14	-1679.627	-20334.709	16.964	335°27'26"	104°16'22"	22.859	2.186	-464831.113031	-3671.664622
9-6	-1664.196	-20341.755	11.796	232°15'46"	76°48'20"	8.212	-16.374	-167046.492060	27249.545304

倍面積	392.244698
面積	196.1223490
地積	196.12㎡

画地面積計算書

現場名：上尾市中平塚区画整理地内

画地番号：3509-4(9-4)

参考資料

※記載内容は換地処分当時のものです。上尾市

点名	Xn	Yn	距離	方向角	測角	Xn+1-Xn-1	Yn+1-Yn-1	Yn*(Xn+1-Xn-1)	Xn*(Yn+1-Yn-1)
9-6	-1664.196	-20341.755	16.964	155°27'26"	103°12'43"	-22.563	-2.163	458971.018065	3599.655948
9-14	-1679.627	-20334.709	11.702	51°10'19"	75°42'53"	-8.094	16.163	164589.134646	-27147.811201
K46	-1672.290	-20325.592	16.739	335°27'17"	104°16'58"	22.563	2.163	-458606.332296	-3617.163270
9-7	-1657.064	-20332.546	11.648	232°14'43"	76°47'26"	8.094	-16.163	-164571.627324	26783.125432

倍面積	382.193091
面積	191.0965455
地積	191.09㎡

画地番号：3509-5(9-5)

点名	Xn	Yn	距離	方向角	測角	Xn+1-Xn-1	Yn+1-Yn-1	Yn*(Xn+1-Xn-1)	Xn*(Yn+1-Yn-1)
9-7	-1657.064	-20332.546	16.739	155°27'17"	103°13'33"	-22.288	-2.160	453171.785248	3579.258240
K46	-1672.290	-20325.592	11.444	53°35'28"	78°08'11"	-8.434	16.164	171426.042928	-27030.895560
9-13	-1665.498	-20316.382	17.024	335°32'05"	101°56'37"	22.288	2.160	-452811.522016	-3597.475680
9-8	-1650.002	-20323.432	11.529	232°13'44"	76°41'39"	8.434	-16.164	-171407.825488	26670.632328

倍面積	378.480672
面積	189.2403360
地積	189.24㎡

画地番号：3509-6(9-6)

点名	Xn	Yn	距離	方向角	測角	Xn+1-Xn-1	Yn+1-Yn-1	Yn*(Xn+1-Xn-1)	Xn*(Yn+1-Yn-1)
9-8	-1650.002	-20323.432	17.024	155°32'05"	103°15'34"	-22.542	-2.057	458130.804144	3394.054114
9-13	-1665.498	-20316.382	11.497	53°43'55"	78°11'50"	-8.694	16.320	176630.625108	-27180.927360
K45	-1658.696	-20307.112	17.314	335°22'54"	101°38'59"	22.542	2.057	-457762.918704	-3411.937672
9-9	-1642.956	-20314.325	11.515	232°16'31"	76°53'37"	8.694	-16.320	-176612.741550	26813.041920

倍面積	385.768998
面積	192.8844990
地積	192.88㎡

画地面積計算書

現場名： 上尾市中平塚区画整理地内

画地番号： 3509-7(9-7)

参考資料

※記載内容は換地処分当時のものです。 上尾市

点名	Xn	Yn	距離	方向角	測角	X _{n+1} -X _{n-1}	Y _{n+1} -Y _{n-1}	Y _n *(X _{n+1} -X _{n-1})	X _n *(Y _{n+1} -Y _{n-1})
9-9	-1642.956	-20314.325	17.314	155°22'54"	103°09'15"	-22.317	-1.275	453354.791025	2094.768900
K45	-1658.696	-20307.112	4.100	143°01'52"	167°38'58"	-19.016	9.678	386160.041792	-16052.859888
K44	-1661.972	-20304.647	9.704	55°11'06"	92°09'14"	2.265	10.433	-45990.025455	-17339.353876
9-12	-1656.431	-20296.679	22.044	335°27'20"	100°16'14"	25.593	-1.190	-519452.905647	1971.152890
9-10	-1636.379	-20305.837	10.738	232°13'39"	76°46'19"	13.475	-17.646	-273621.153575	28875.543834

倍面積	450.748140
面積	225.3740700
地積	225.37㎡

画地番号： 3509-8(9-8)

点名	Xn	Yn	距離	方向角	測角	X _{n+1} -X _{n-1}	Y _{n+1} -Y _{n-1}	Y _n *(X _{n+1} -X _{n-1})	X _n *(Y _{n+1} -Y _{n-1})
9-10	-1636.379	-20305.837	22.044	155°27'20"	103°14'47"	-26.861	0.377	545435.087657	-616.914883
9-12	-1656.431	-20296.679	11.528	55°16'04"	79°48'44"	-13.484	18.631	273680.419636	-30860.965961
K43	-1649.863	-20287.206	15.931	333°04'03"	97°47'59"	20.771	2.258	-421385.555826	-3725.390654
K42	-1635.660	-20294.421	6.636	336°36'26"	183°32'23"	20.293	-9.850	-411834.685353	16111.251000
9-11	-1629.570	-20297.056	11.111	232°12'33"	75°36'07"	-0.719	-11.416	14593.583264	18603.171120

倍面積	488.849378
面積	244.4246890
地積	244.42㎡